

BellSouth Telecommunications, Inc.
150 South Monroe Street
Suite 400
Tallahassee, Florida 32301

marshall.criser@bellsouth.com

Marshall M. Criser III
Vice-President
Regulatory & External Affairs

(850) 224-7798
Fax (850) 224-5073

April 15, 2005

Ms. Beth Salak, Director
Division of Competitive Markets & Enforcement
Florida Public Service Commission
2540 Shumard Oak Boulevard
Tallahassee, Florida 32399-0850

Dear Ms. Salak:

Pursuant to Florida Statue 364.051, we are filing herewith revisions to our General Subscriber Services Tariff, Exchange Service Area Maps. Following are the affected pages:

St. Augustine Exchange – Base Rate Area Map	-	Eighth Revised Page
St. Augustine Exchange – Service Area	-	Thirteenth Revised Page 1
	-	Ninth Revised Page 2
	-	Eighth Revised Page 3
St. Johns County - Interim Foreign Exchange	-	First Revised Page 1
St. Johns Exchange – Service Area	-	Third Revised Page 1

The purpose of this filing is to correct Exchange Boundary Areas. The exchanges, St. Johns and St. Augustine, for this filing are in BellSouth's certificated territory.

Acknowledgement, date of receipt and authority number of this filing are requested.

Your consideration and approval will be appreciated.

Yours truly,

Marshall M. Marshall M. Criser III (slg)

Marshall M. Criser III
Vice President-Regulatory/Bellsouth

Attachments

EXECUTIVE SUMMARY

Introduction:

Prior to the establishment of the St. Johns Exchange, BellSouth established service to several customers from the St. Augustine exchange. When the St. Johns Exchange Map was originally drawn, the map included the two areas being moved that should have been shown on the St. Augustine maps. This filing is to correct the exchange boundary areas to reflect how service is being provided to the two areas. Telephone service to the customers, forty-one customers in West section and twenty-five customers in the East section, in these areas will not be impacted by this tariff filing. BellSouth is merely correcting its maps to reflect how service is being provided.

Cost Information:

There is no cost associated with this boundary change.

BellSouth
TELECOMMUNICATIONS, INC.

Florida
Issued: April 15, 2005
By: Joseph P. Lacher, President - FL

Miami, Florida

~~SOUTHERN BELL TELEPHONE
AND TELEGRAPH COMPANY
FLORIDA~~


ST. AUGUSTINE, FLA. Exchange
Eighth ~~Seventh~~ Revised Sheet Page
Cancelling ~~Sixth~~ Revised Sheet Page
3 Seventh

BASE RATE AREA MAP

ISSUED: June 21, 1985

EFFECTIVE: August 20, 1985

April 30, 2005

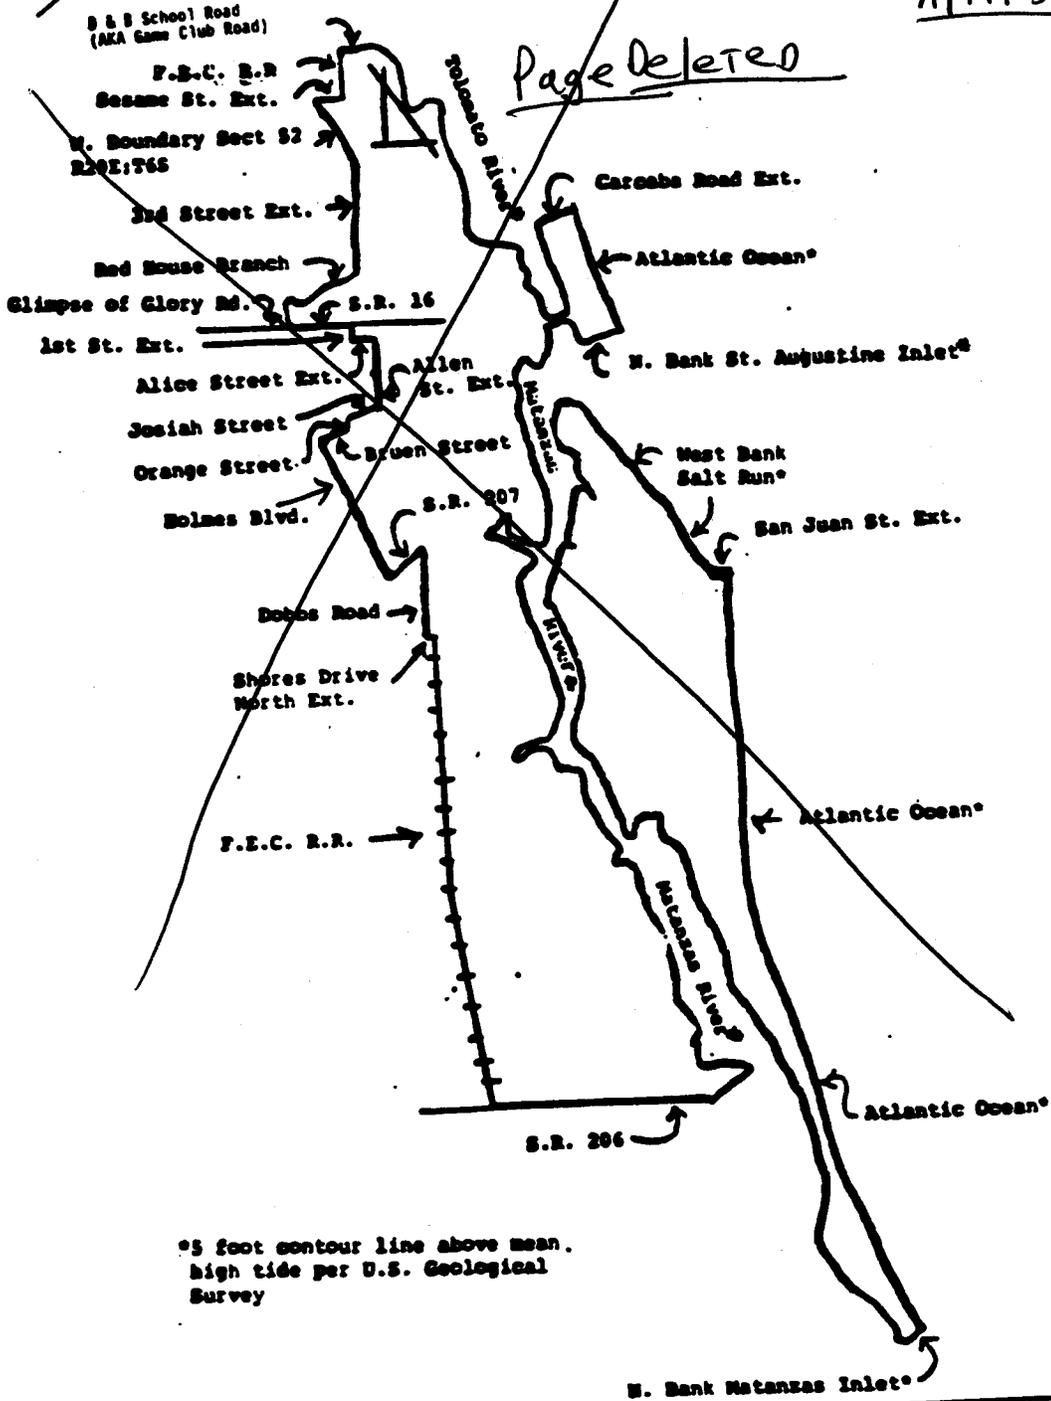

*5 foot contour line above mean high tide per U.S. Geological Survey

~~By: Walter H. Aiford, Vice President, Miami, Florida~~

01445

BELLSOUTH
TELECOMMUNICATIONS, INC.
FLORIDA

Issued: ~~July 31, 1998~~
April 15, 2005


Thirteenth

ST. AUGUSTINE, FLA. Exchange
~~Twelfth Revised Sheet 1~~ page
Canceling ~~Eleventh Revised Sheet 1~~
Effective: ~~August 15, 1998~~ Page

Twelfth April 30, 2005


BY: Joseph P. Lacher, President **EXCHANGE SERVICE AREA MAP**
NORTH EASTERN PART

Miami, Florida FL St. Augustine Exchange Service Area Map

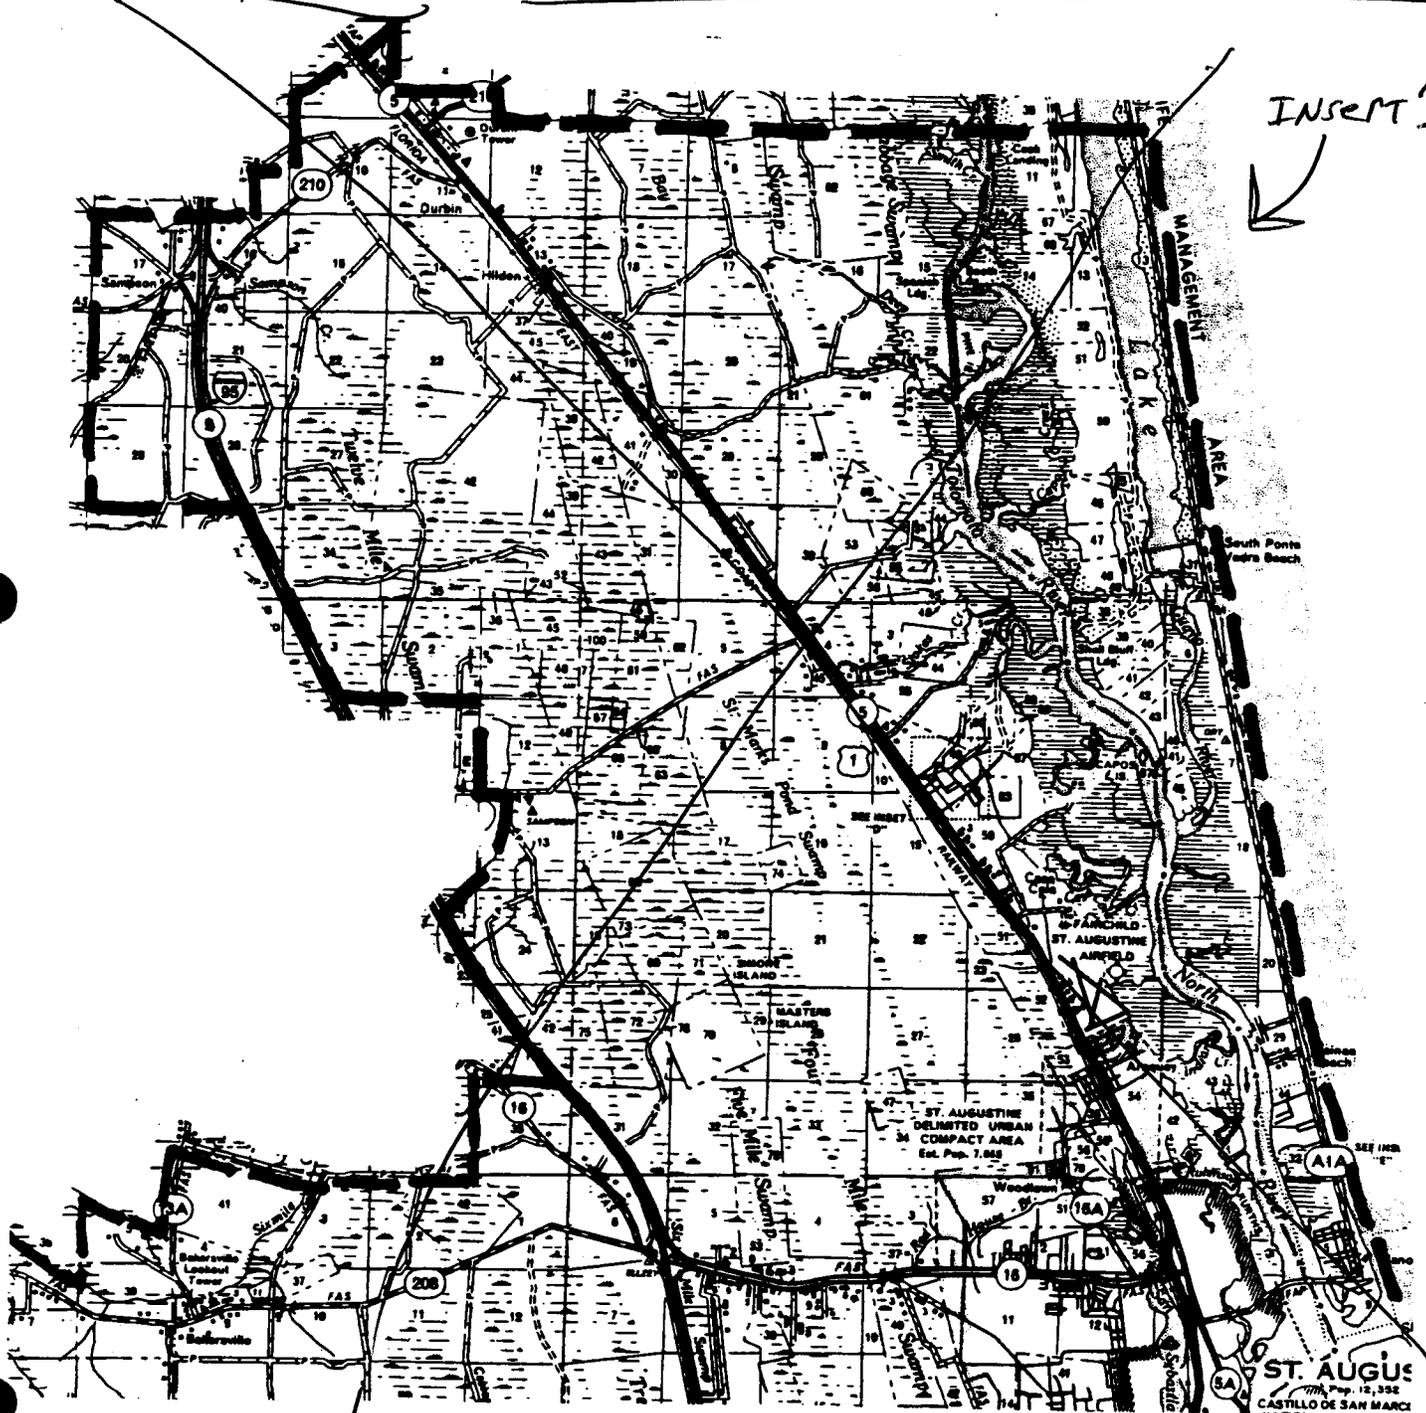

ISSUED BY: Joseph P. Lacher, President-FI
Miami, Florida

Insert 1

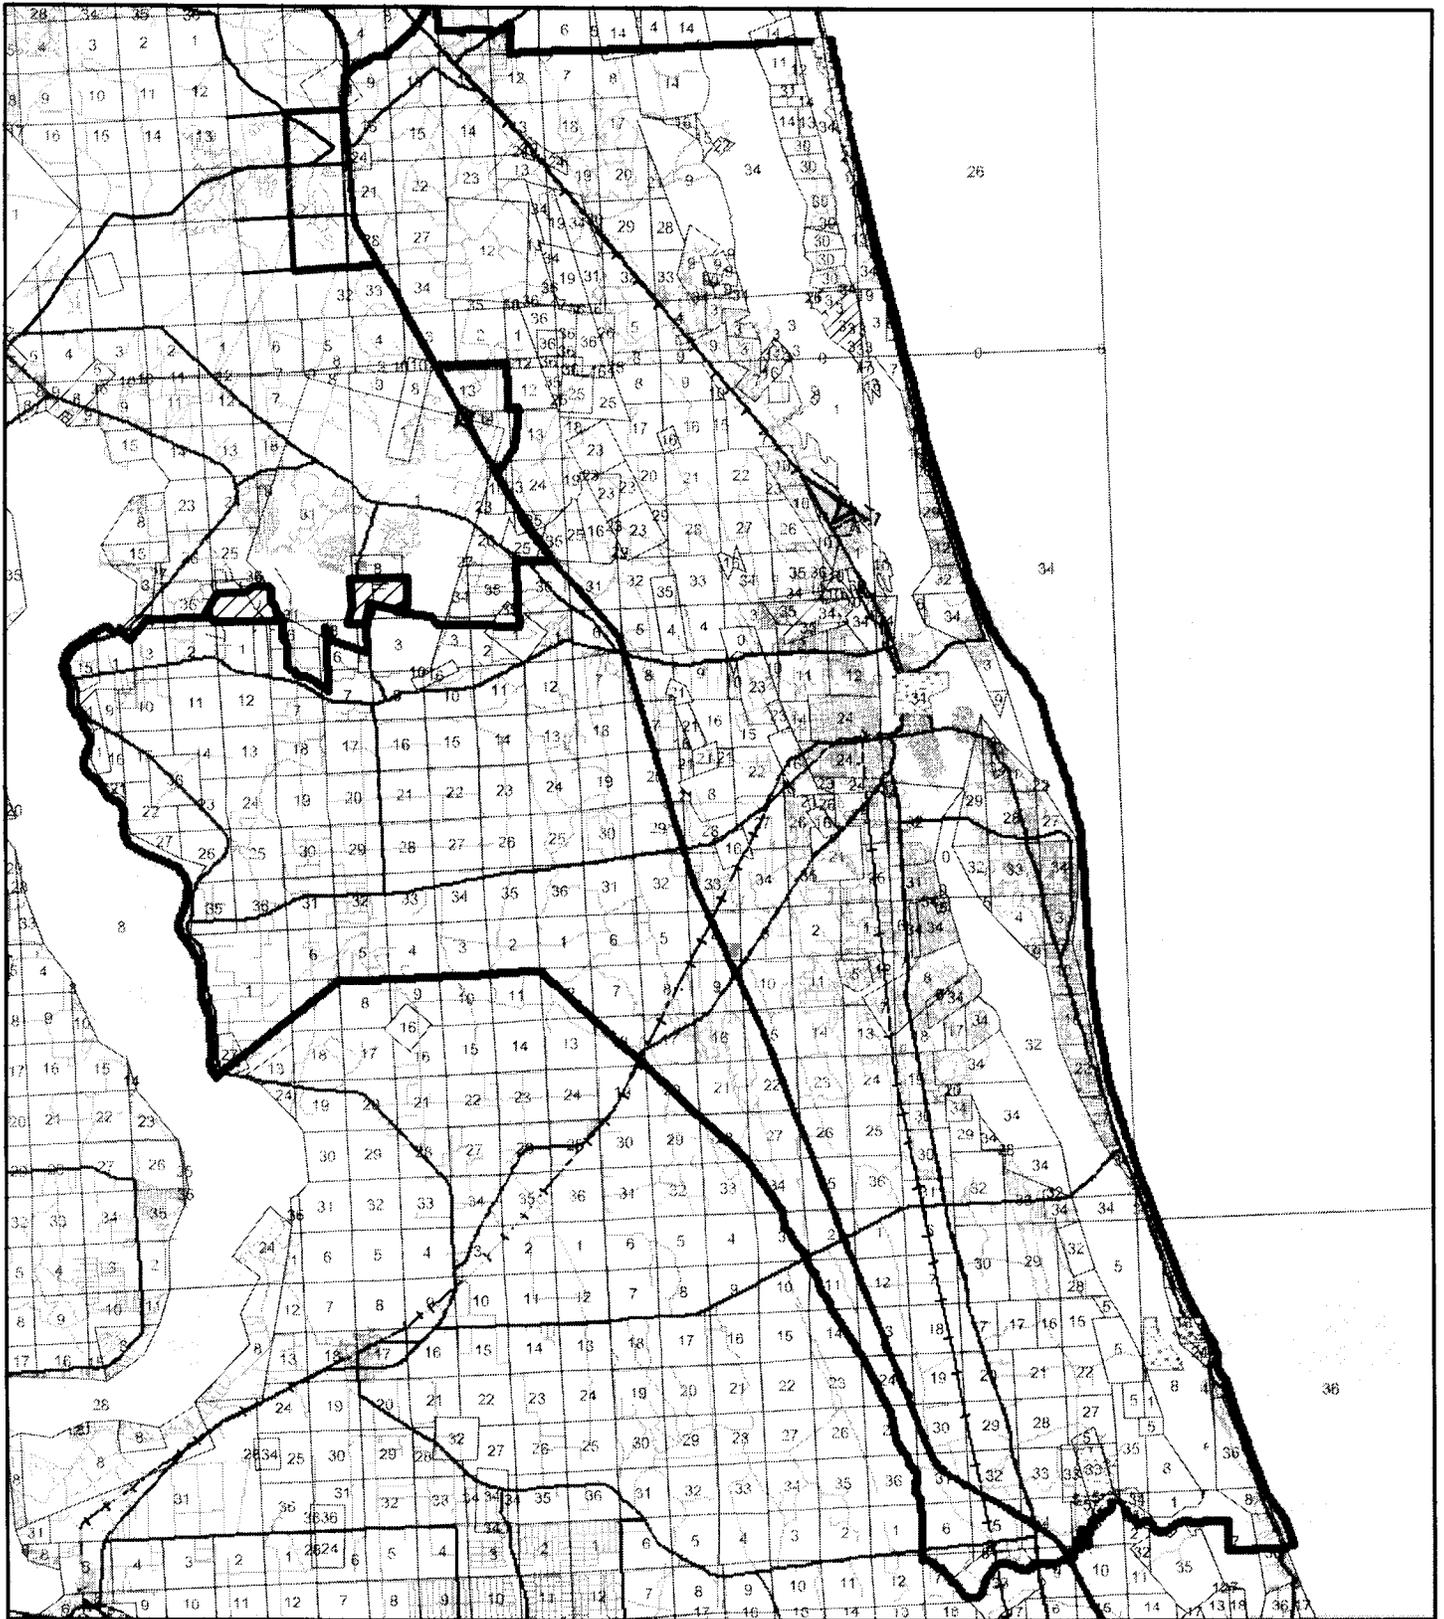

Bellsouth
Telecommunications, Inc.

Florida
Issues: April 15, 2005

BY: Joseph P. Lacher, President FL
Miami, Florida

Exchange


SOUTHERN BELL TELEPHONE
AND TELEGRAPH COMPANY
FLORIDA

Ninth ST. AUGUSTINE, FL
~~Eight~~ Revised Sheet 2
~~Seventh~~ Revised Sheet 2
8 Eighth Page

ISSUED: ~~May 24, 1989~~ April Page Deleted

EFFECTIVE: ~~SEP 05 1989~~
April 30, 2005

EXCHANGE SERVICE AREA MAP
SOUTH EASTERN PART

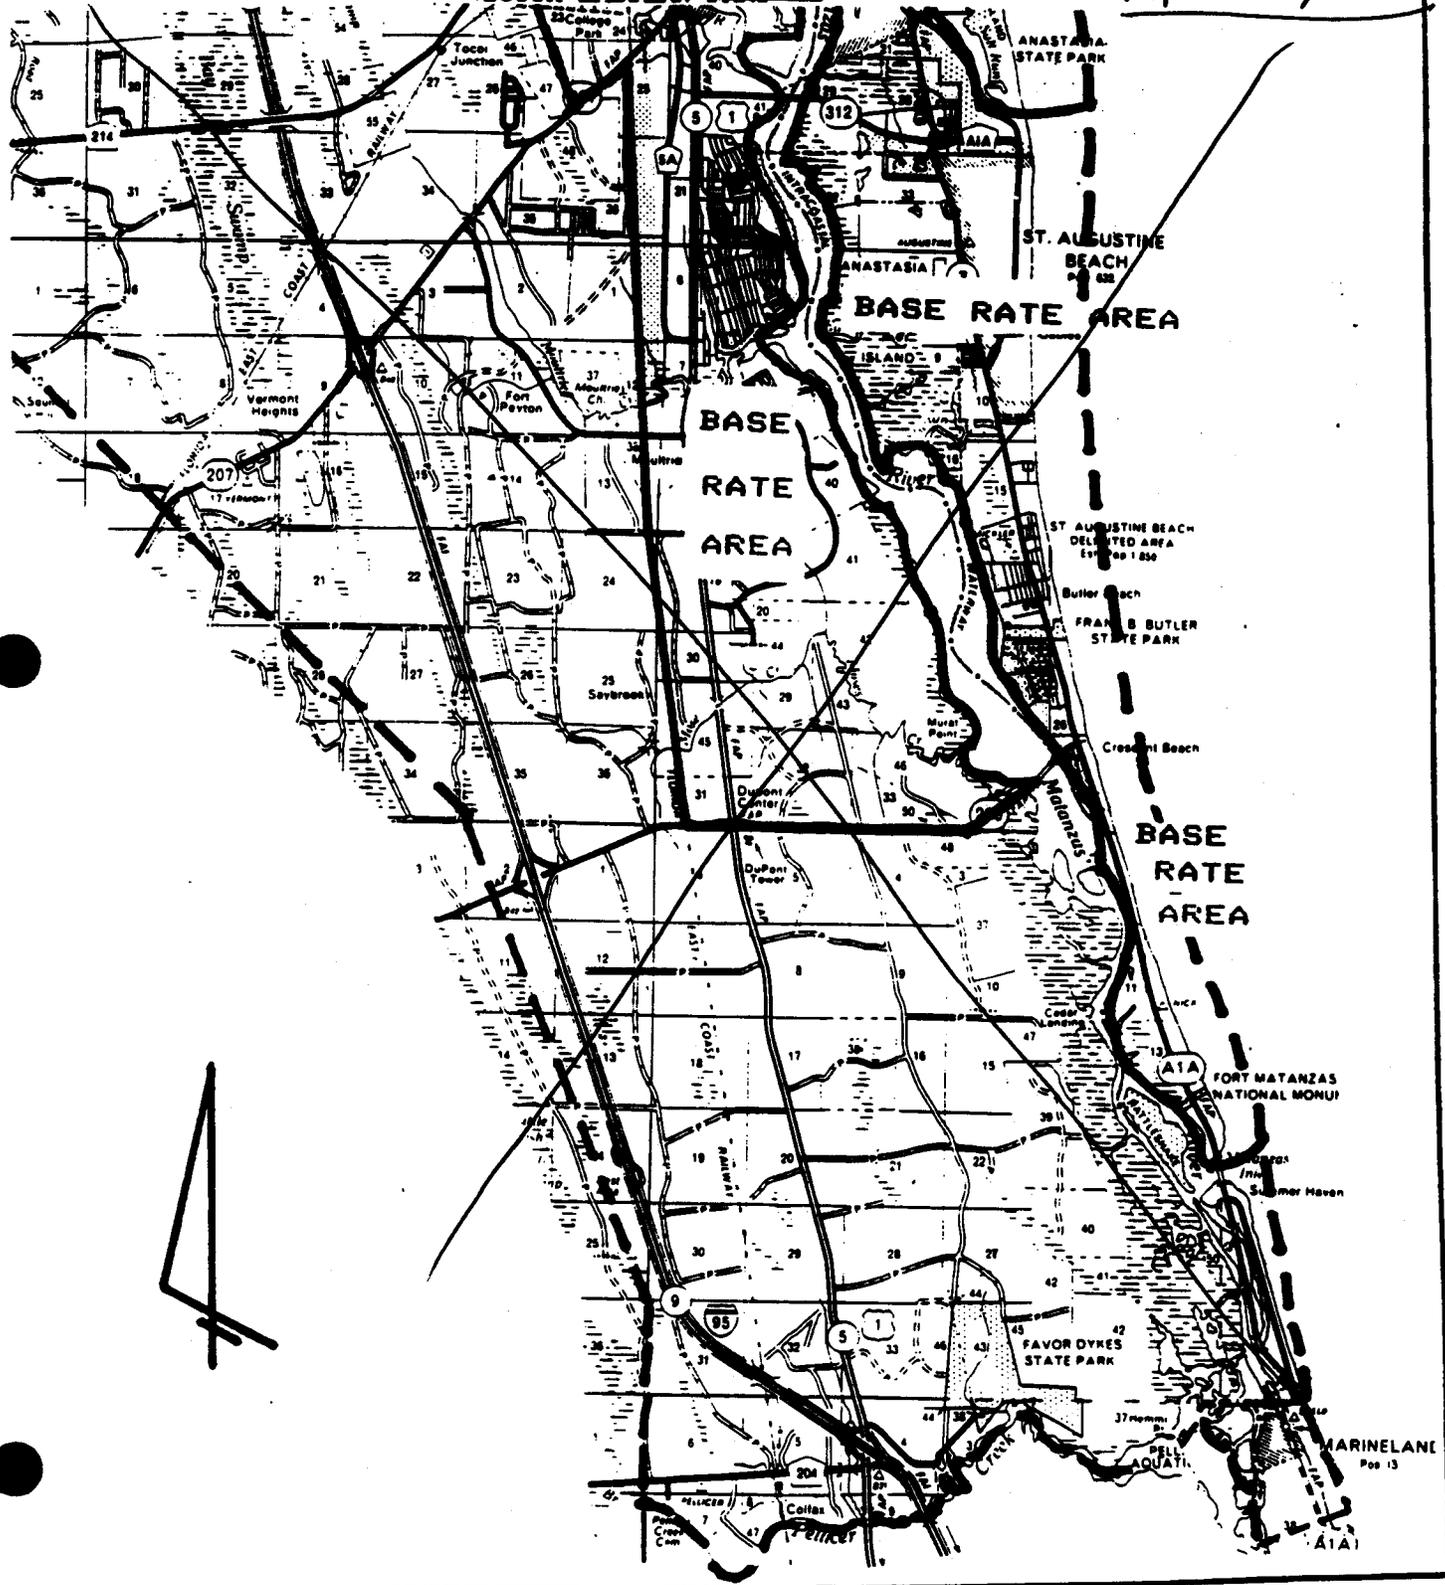

BY: H. C. Henry, Vice President - Florida

BELLSOUTH
TELECOMMUNICATIONS, INC.
FLORIDA


Issued: July 31, 1998

Issued By: Joseph P. Lacher, President - FL

Miami, Florida

Page Deleted

**EXCHANGE SERVICE AREA MAP
WESTERN PART**

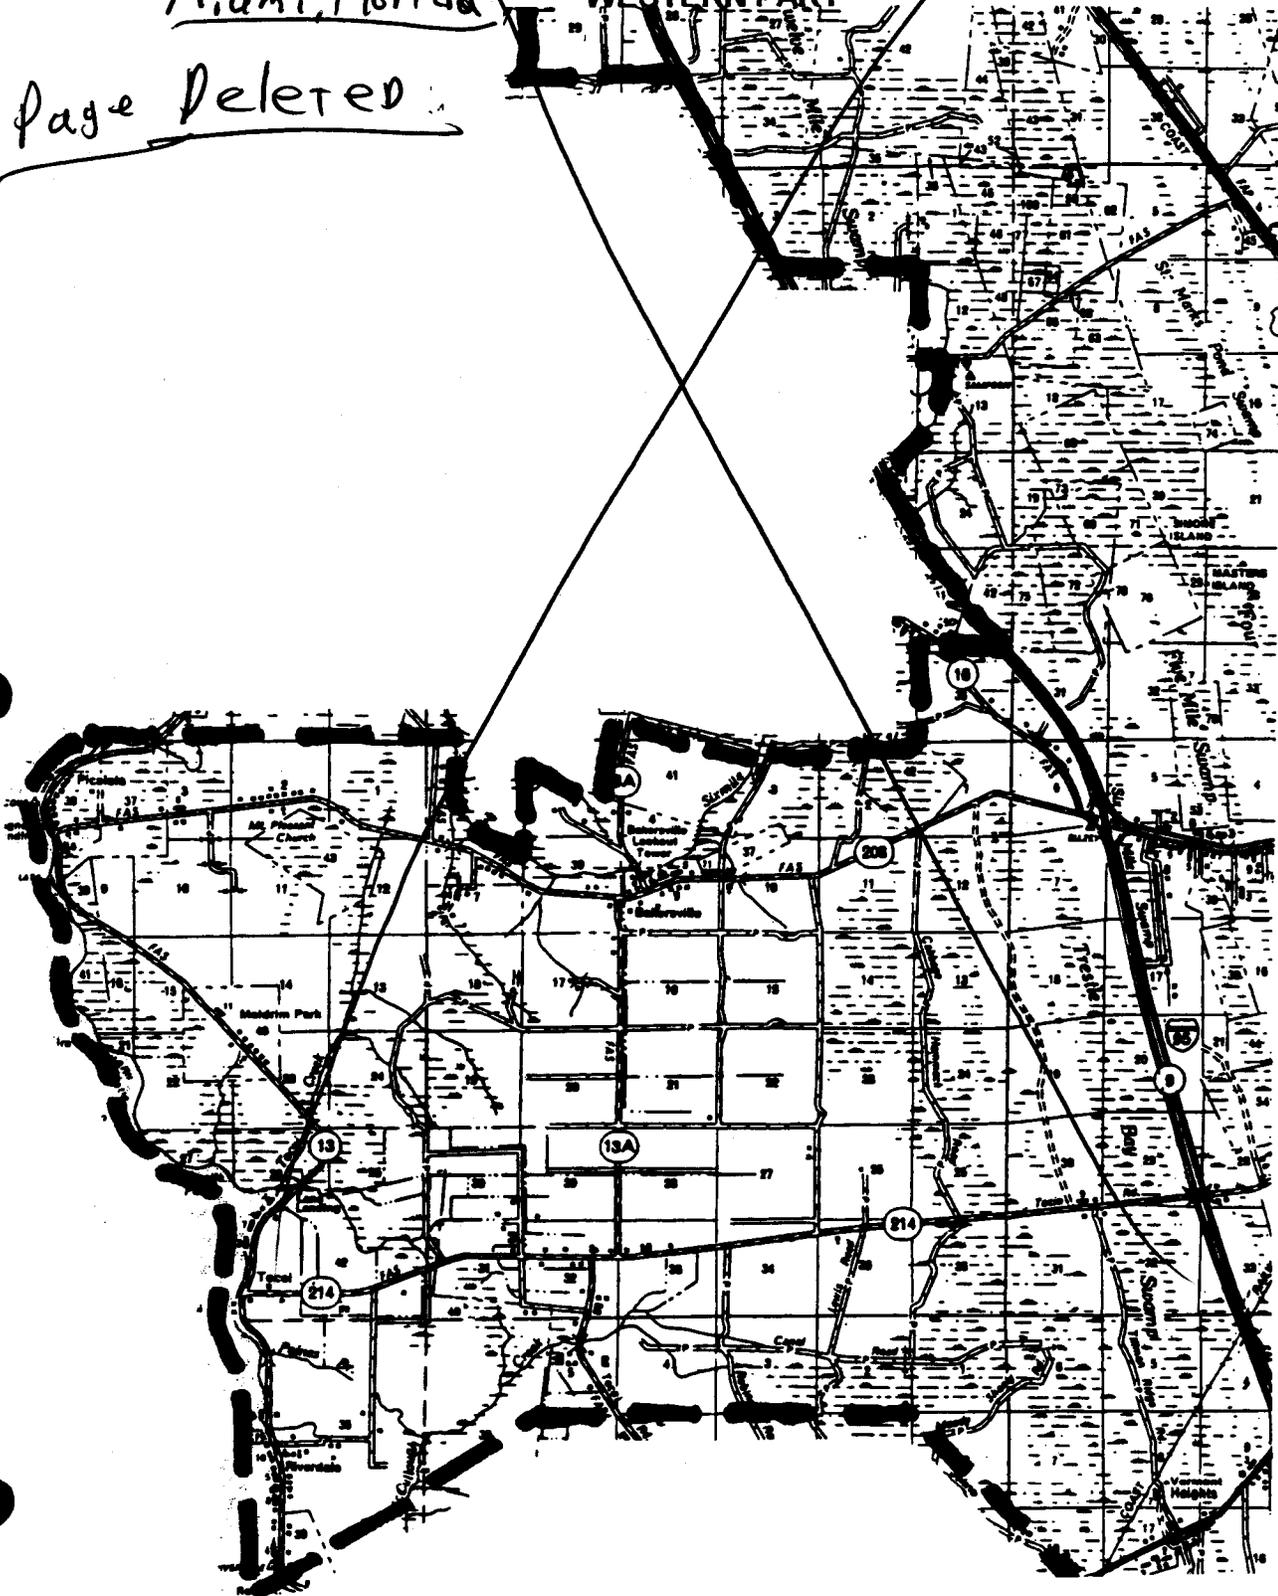

Eighth

ST. AUGUSTINE, FLA. Exchange
~~Seventh Revised Sheet 3~~ Page
~~Canceling Sixth Revised Sheet 3~~ Page
Effective: ~~August 15, 1998~~
April 30, 2005

~~ISSUED BY: Joseph P. Lacher, President - FL~~
~~Miami, Florida~~

BellSouth Telecommunications, Inc
Florida

~~SOUTHERN BELL TELEPHONE AND TELEGRAPH COMPANY~~

First Revised Page
Cancel

~~ST. JOHNS COUNTY, FLORIDA~~

~~ORIGINAL SHEET NO. 1~~

ISSUED: ~~May 2, 1978~~

EFFECTIVE: ~~June 1, 1978~~

April 15, 2005

April 30, 2005

INTERIM FOREIGN EXCHANGE AREAS

Issued By: Joseph P. Lacher, President TFL

Miami, Florida Deleted

Page

R 28 E

R 29 E

T 8 S

T 9 S

T 10 S

NORTH
FLORIDA

TELEPHONE CO.

AREA

ST. AUGUSTINE

EXCHANGE

AREA

INTERIM
FOREIGN
EXCHANGE

AREA
NO. 1

PALATKA

EXCHANGE

AREA

BUNNELL EXCHANGE AREA

FLAGLER

COUNTY

BY: W. W. Sessoms, Vice President, Miami, Florida

BELLSOUTH
TELECOMMUNICATIONS, INC.
FLORIDA

Issued: ~~July 31, 1998~~ April 15, 2005


Third ST. JOHNS, FLA. Exchange
Second- Revised Sheet Page
Canceling First Revised Sheet Page
Effective: ~~August 15, 1998~~
April 30, 2005

Issued By: ST. JOHN'S EXCHANGE SERVICE AREA MAP


Joseph P. Lacher, President, FL
Miami, Florida

Second

INSERT 2

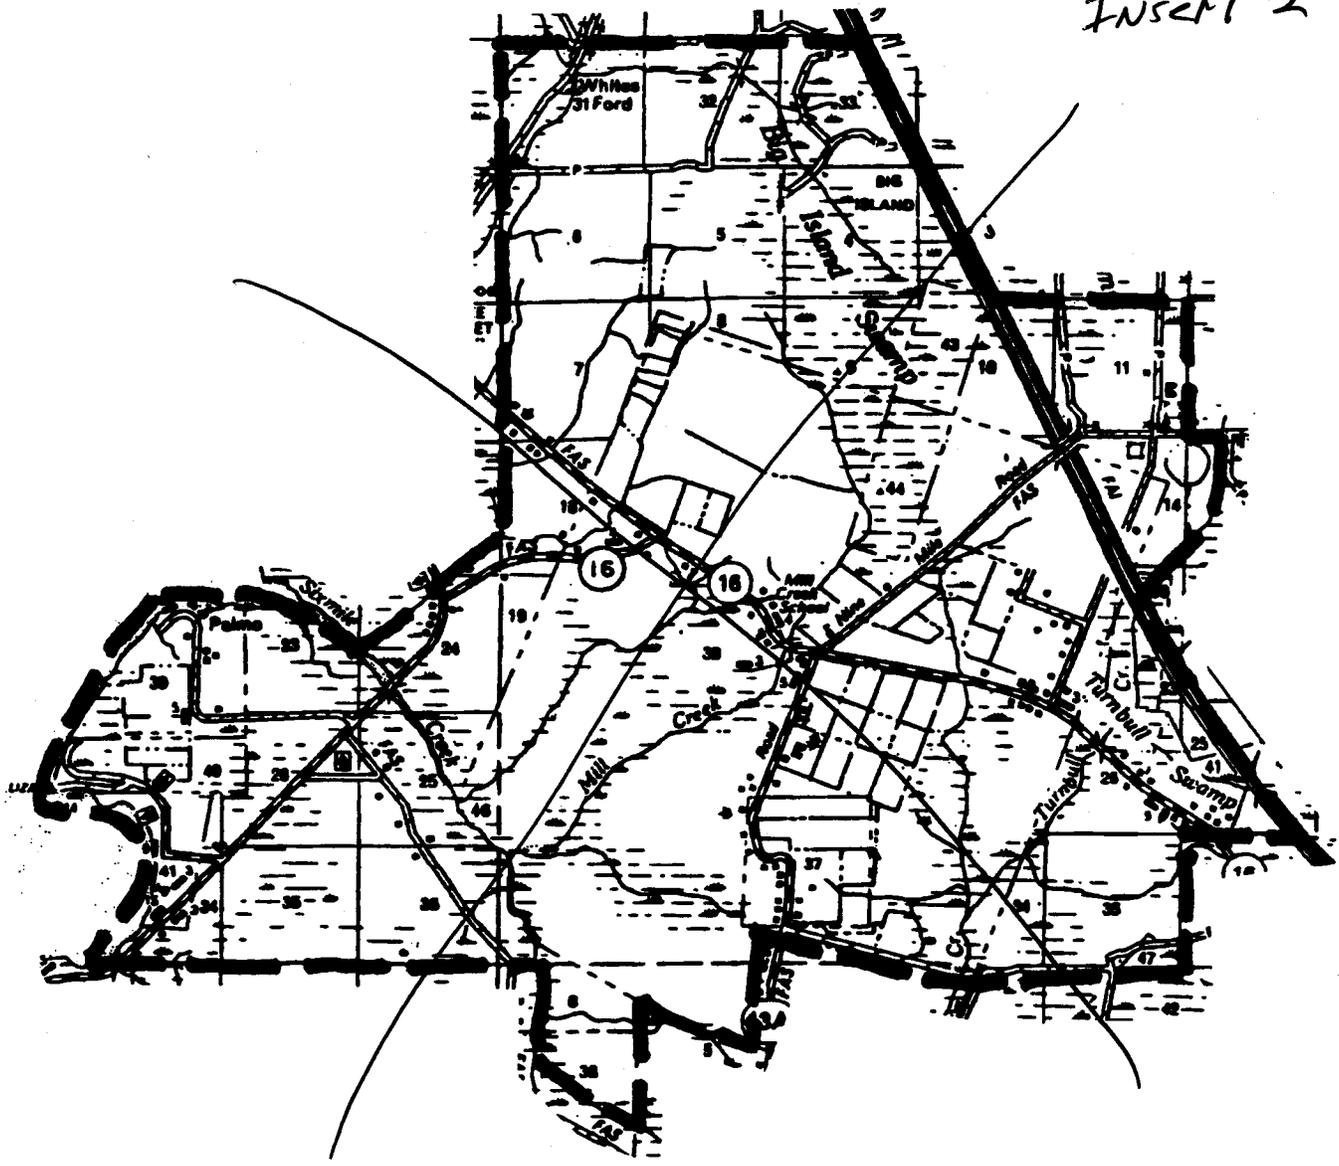

ISSUED BY: Joseph P. Lacher, President-FL
Miami, Florida

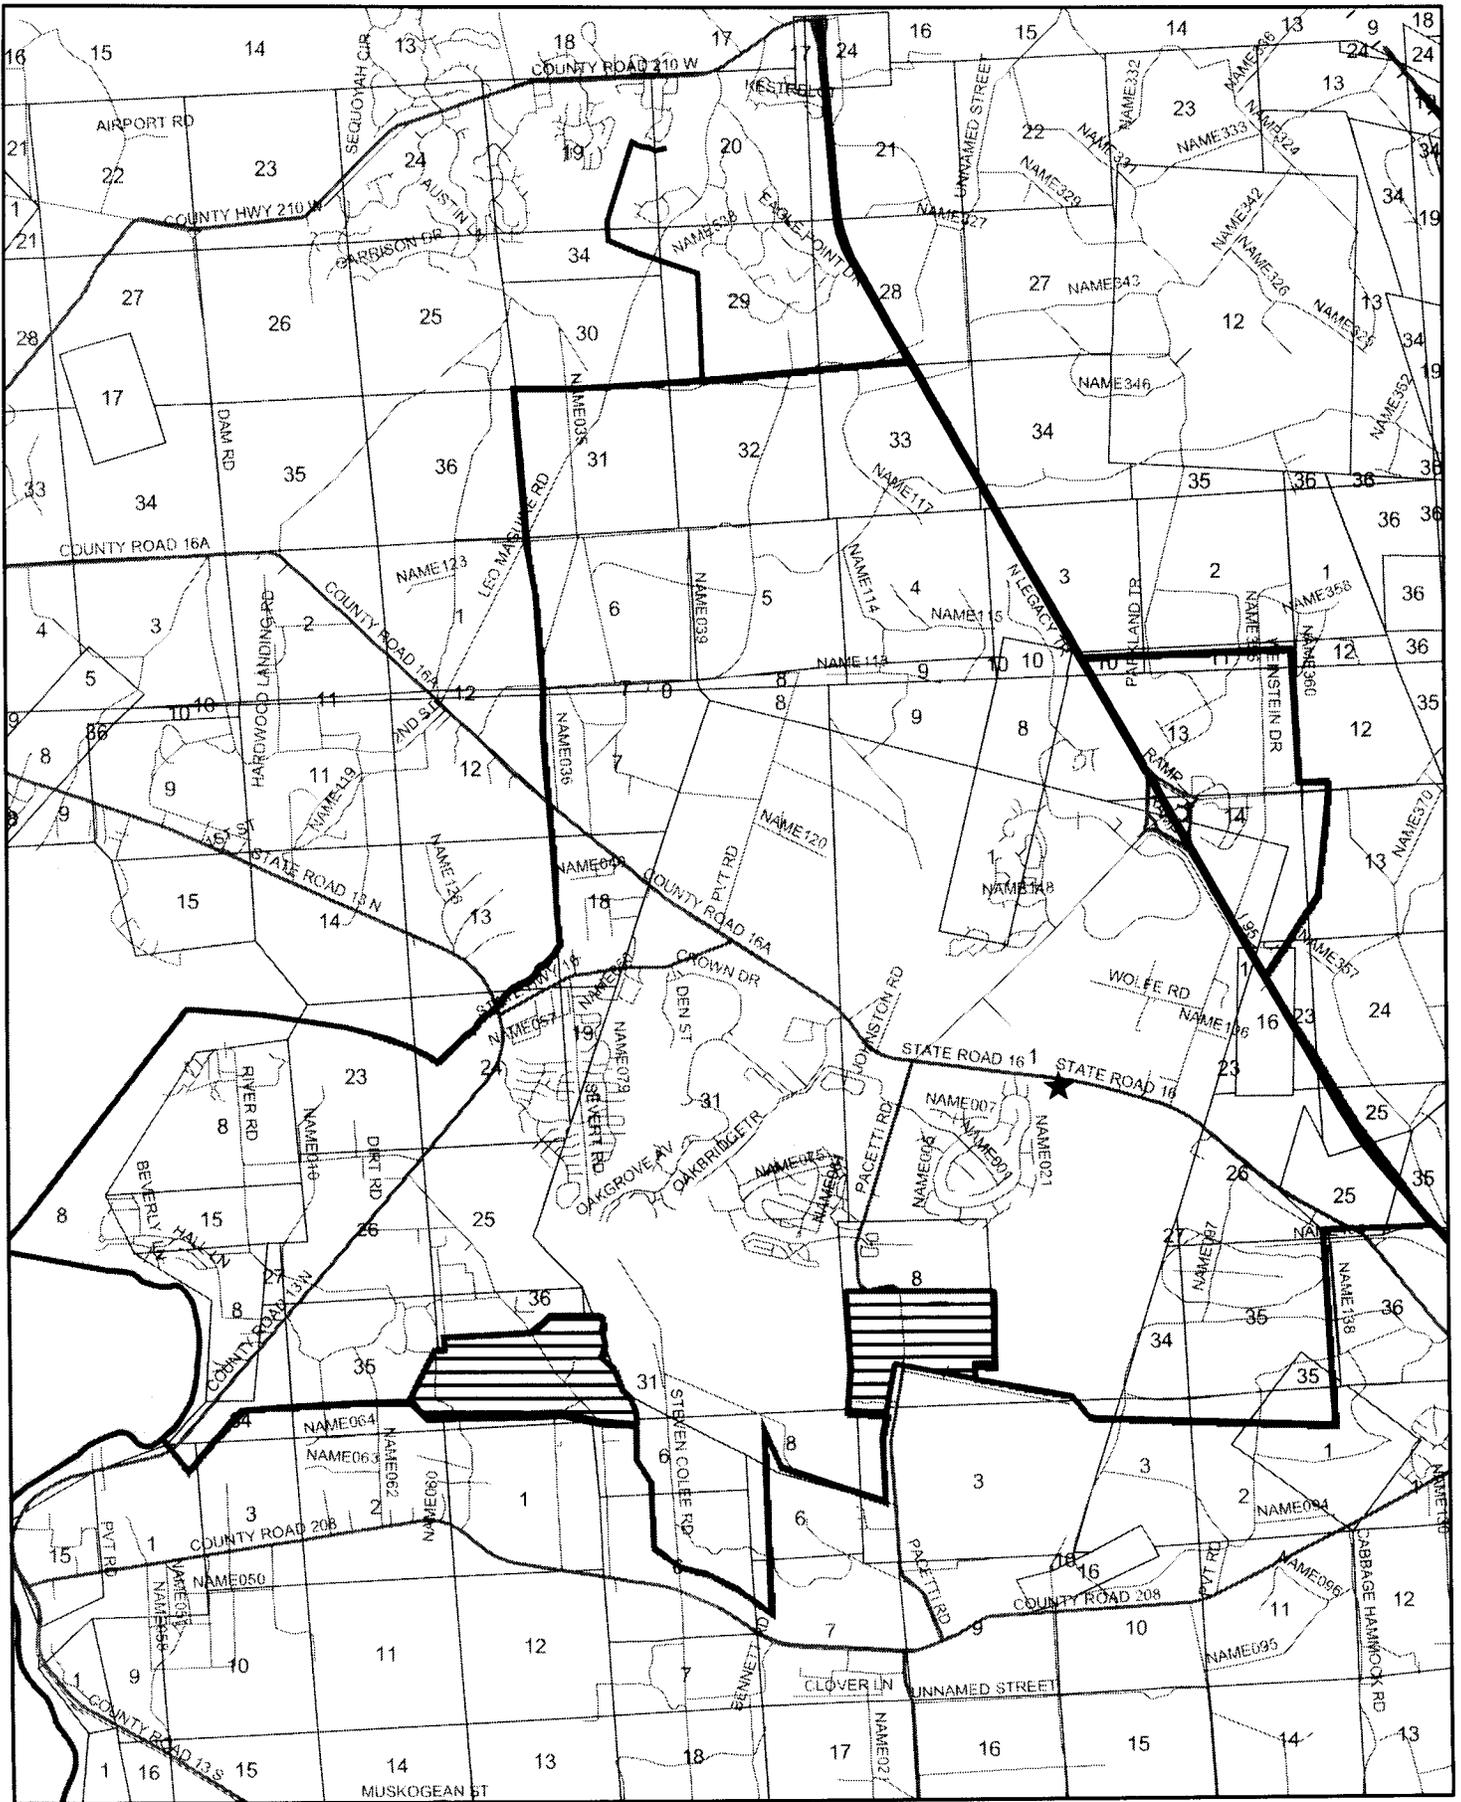

BELLSOUTH
TELECOMMUNICATIONS, INC.
FLORIDA
ISSUED: April 15, 2005
BY: Joseph P. Lacher, President -FL
Miami, Florida


ST. AUGUSTINE EXCHANGE
Eighth Revised Page
Cancels Seventh Revised Page

EFFECTIVE: April 30, 2005

Base Rate Area Map

Page Deleted

St. Augustine Exchange Service Area Map

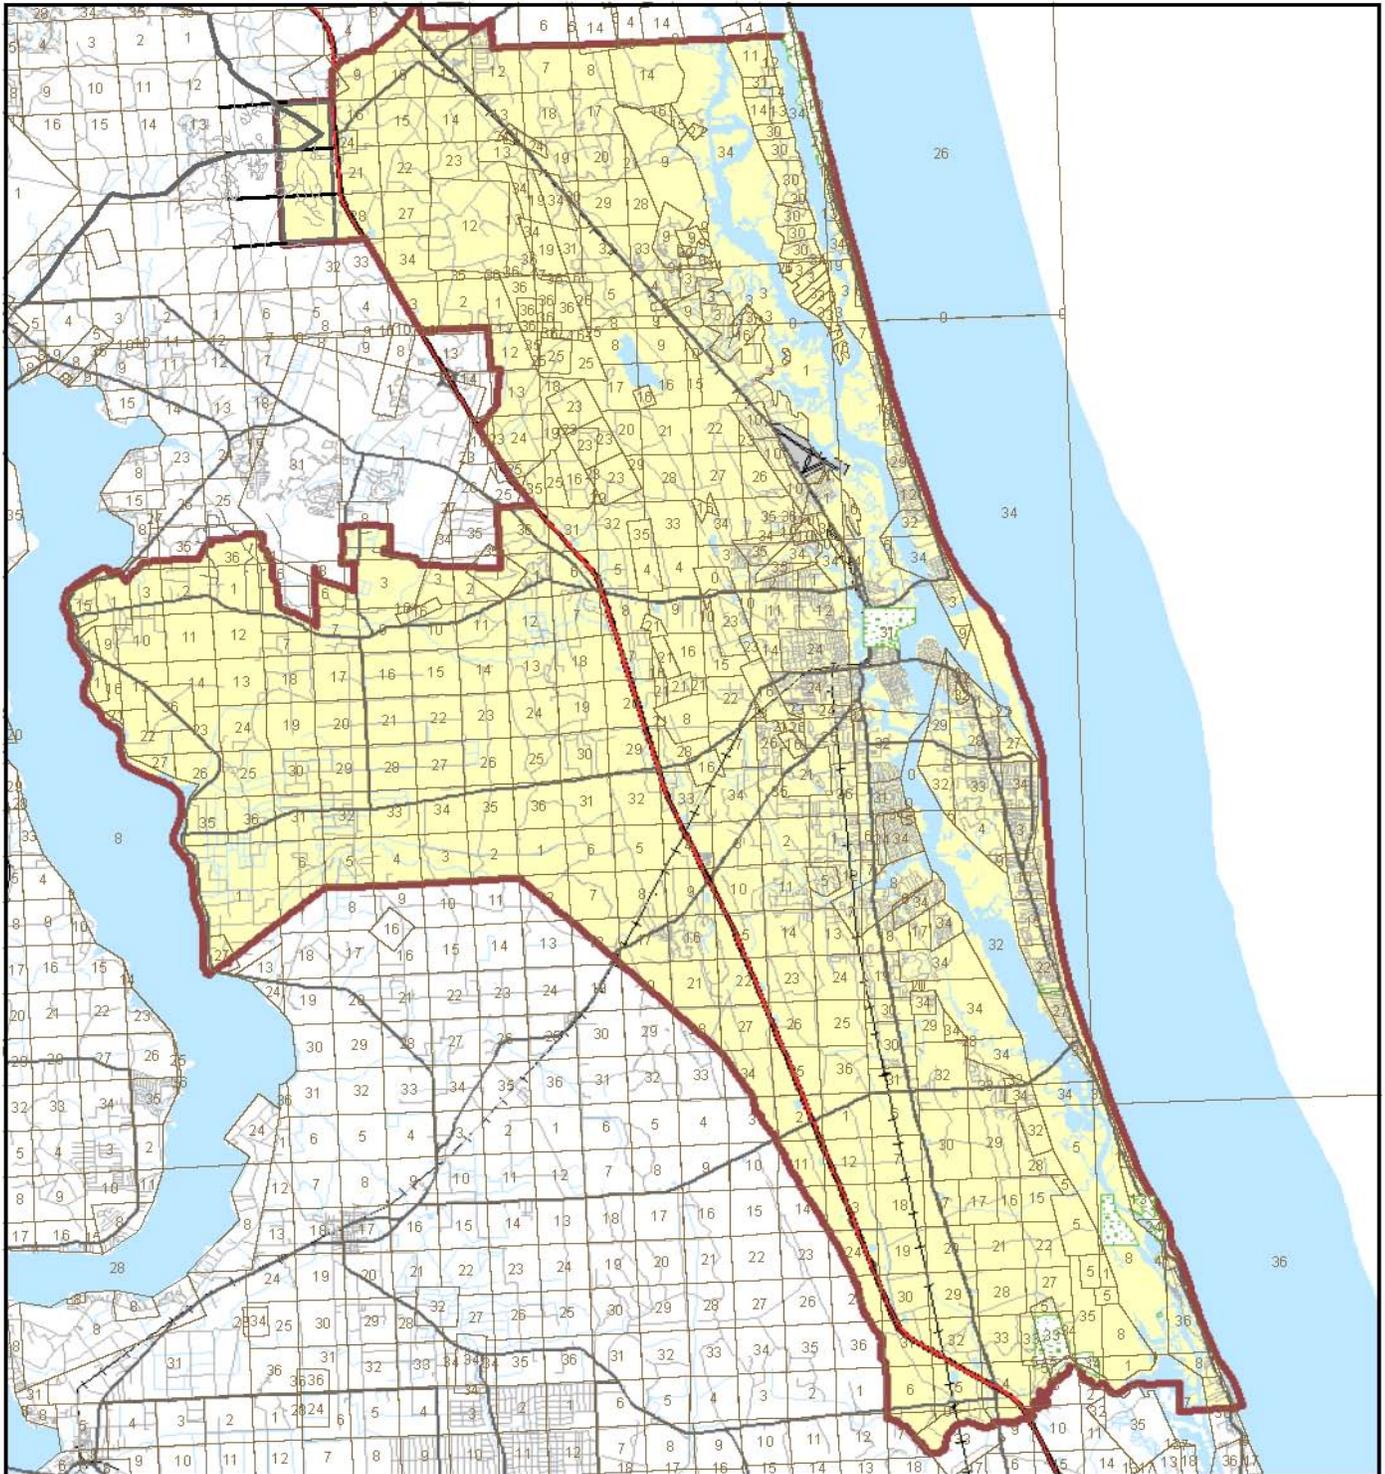

BELLSOUTH
TELECOMMUNICATIONS, INC.
FLORIDA
ISSUED: April 15, 2005
BY: Joseph P. Lacher, President -FL
Miami, Florida

ST. AUGUSTINE EXCHANGE
Ninth Revised Page 2
Cancels Eighth Revised Page 2

EFFECTIVE: April 30, 2005

Page Deleted

BELLSOUTH
TELECOMMUNICATIONS, INC.
FLORIDA
ISSUED: April 15, 2005
BY: Joseph P. Lacher, President -FL
Miami, Florida

ST. AUGUSTINE EXCHANGE
Eighth Revised Page 3
Cancels Seventh Revised Page 3

EFFECTIVE: April 30, 2005

Page Deleted

BELLSOUTH
TELECOMMUNICATIONS, INC.
FLORIDA
ISSUED: April 15, 2005
BY: Joseph P. Lacher, President -FL
Miami, Florida

ST. JOHNS COUNTY
First Revised Page 1
Cancels Original Revised Page 1


EFFECTIVE: April 30, 2005

INTERIM FOREIGN EXCHANGE AREAS

Page Deleted

EFFECTIVE: April 30, 2005

St. Johns Exchange Service Area Map

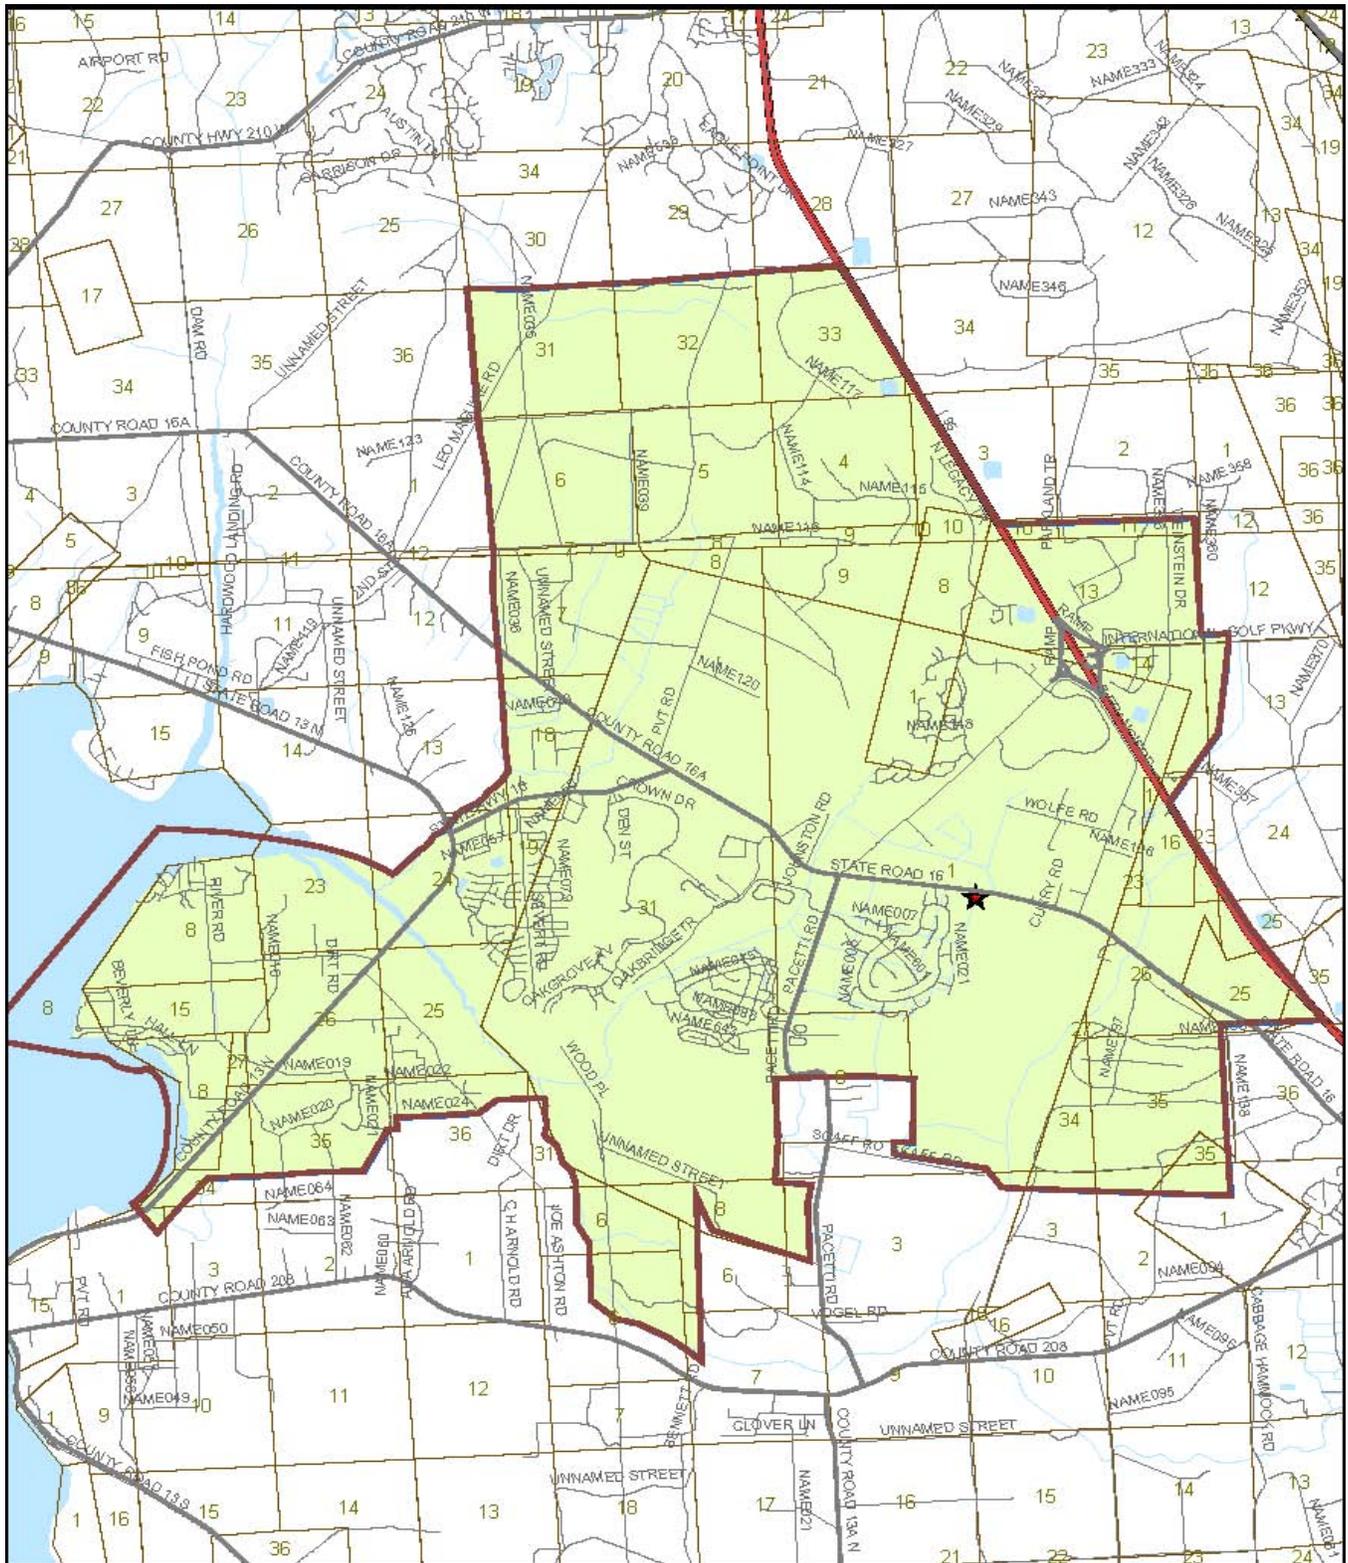

All BellSouth marks contained herein and as set forth in the trademarks and servicemarks section of this Tariff are owned by BellSouth Intellectual Property Corporation.