

DTH ____

Maltese Developments, Inc

Rio Villa Lakes LLC Hunter Creek Estates LLC Waterfront Homes of Charlotte LLC MSM Utilities LLC

ORIGINAL

CISTRISPINCT CENTER

05 HOV 15 MM 10: 42

November 14, 2005

VIA OVERNIGHT MAIL

Blanca S. Bayo, Director Division of the Commission Clerk & Administrative Services Florida Public Service Commission 2540 Shumard Oak Boulevard Tallahassee, F 32399-0850

RE: Docket No. 050820-WS

Dear Director Bayo;

Please be advised that MSM Utilities is amending its application for amendment of Certificates 611-W and 527-S to extend water and wastewater services in Charlotte County. The amendment will remove certain areas that were included in the original submission. We will submit an amended application for the commission's consideration.

In the meantime, please find the enclosed communication notifying all property owners who received the Legal Notice of October 18, 2005 and referenced in Exhibit N of our application, of our intention to amend the application. The net effect of the amendment is to remove the areas where property owners have objected to being included in the service territory and retain those areas of future development where the property owners have expressed an interest in having water and wastewater services available. The eight property owners along Hunter Creek Drive who remain in the area to be added (as of this writing none of these residents filed objections with the Public Service Commission), will receive the letter and will personally be contacted by me to discuss the amendment.

CMP	be contacted by me to discuss the amendment.
MCD	
CTR	If you have any questions, please do not hesitate to contact me at the office or on my mobile phone: (239) 273-8700. Thank you.
ECR	
GCL.	Respectfully,
OPC	& / Waltine
RCA	Ben J. Maltese Managing Partner
SOR	MSM Utilities
§ GA	
3EC	

DOCUMENT NUMBER-DATE

NOTICE TO AMEND APPLICATION SERVICE TERRITORY EXPANSION

This notice is to inform you that MSM Utilities is amending its application to the Public Service Commission to remove certain areas from the proposed territory expansion.

While it was never the intention of MSM Utilities to compel anyone to connect to its water or wastewater system, we did want to make it available to those who wanted the service. Expansion of the service territory would allow us to offer the service to anyone in the service area that wanted to connect to the system.


However, due to the objections of the residents of certain areas included in the proposed expanded territory, MSM Utilities will amend its application to the Public Service Commission to remove certain areas from the proposed territory. The net effect of the amendment is to remove the areas where property owners have objected to being included in the service territory and retain those areas of future development where the property owners have expressed an interest in having water and wastewater services available. See enclosed map showing the revised proposed territory expansion.

If you have question you may contact us between 9:00 – 5:00 M-F at (239) 444-1444.

Respectfully,

Ben J. Maltese Managing Partner

MSM Utilities

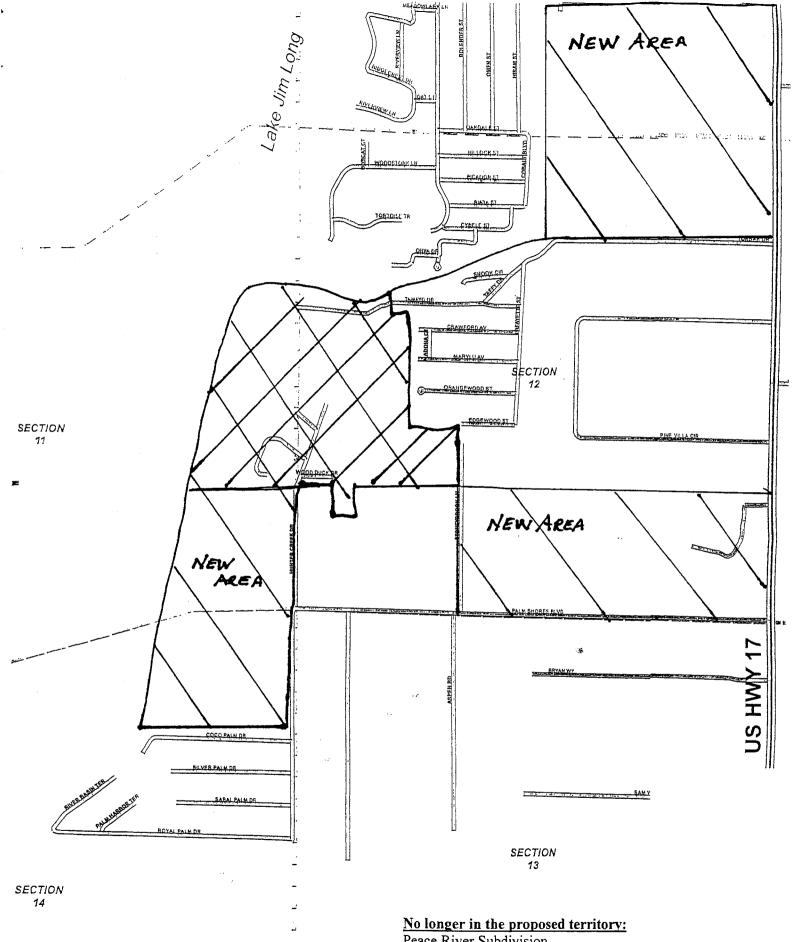

Peace River Subdivision

Southside of Turbak Drive Pine Villa Subdivision Palm Shores between Stoneybrook and Hunter Creek Drive Property south of Palm Shores west of US 17