

**David B. Erwin
Attorney At Law**

127 Riversink Road
Crawfordville, Florida 32327

Telephone 850.926.9331
d.b.erwin@gmail.com

April 8, 2008

Ann Cole, Commission Clerk
Office of Commission Clerk
Florida Public Service Commission
2540 Shumard Oak Boulevard
Tallahassee, FL 32399-0850

RECEIVED-PPSC
08 APR - 8 AM 11: 05
COMMISSION
CLERK

In Re: ITS Telecommunications Systems, Inc. -
Docket No. 070738-TL
Transfer of Territory

Dear Ms. Cole:

The Florida Public Service Commission issued Order No. PSC-08-0106-PAA-TL, Docket No. 070738-TL, on February 19, 2008. The Order approved a Joint Petition to Transfer Territories from ITS Telecommunications Systems, Inc. to AT&T Florida. The territory transferred is comprised of six uninhabited lots in Sunlight Ranch, located in the northeast quarter of Section 4, Township 40 South, Range 40 East, Martin County, Florida.

Submitted herewith is a map that depicts the territory transferred and removed from the ITS Telecommunications Systems, Inc.'s territory and added to the Stuart Main Exchange of AT&T Florida. Also submitted herewith is Seventh Revised Sheet 1, Section 3, a tariff sheet that identifies the territory transferred and cites the authority for the transfer.

_____ Please see that the tariff sheet is accepted for filing pursuant to an Ordering Paragraph of
Order No. PSC-08-0106-PAA-TL.

- CMP 1
- COM _____
- CTR _____
- ECR _____
- GCL 1
- OPC _____
- RCA _____
- SCR _____
- SGA _____
- SEC _____
- OTH _____

Sincerely,




David B. Erwin

_____ DBE:jm
Copy: Jeff Bates
Mary Ann Holt

DOCUMENT NUMBER-DATE

02687 APR - 8 8

COMMISSION CLERK

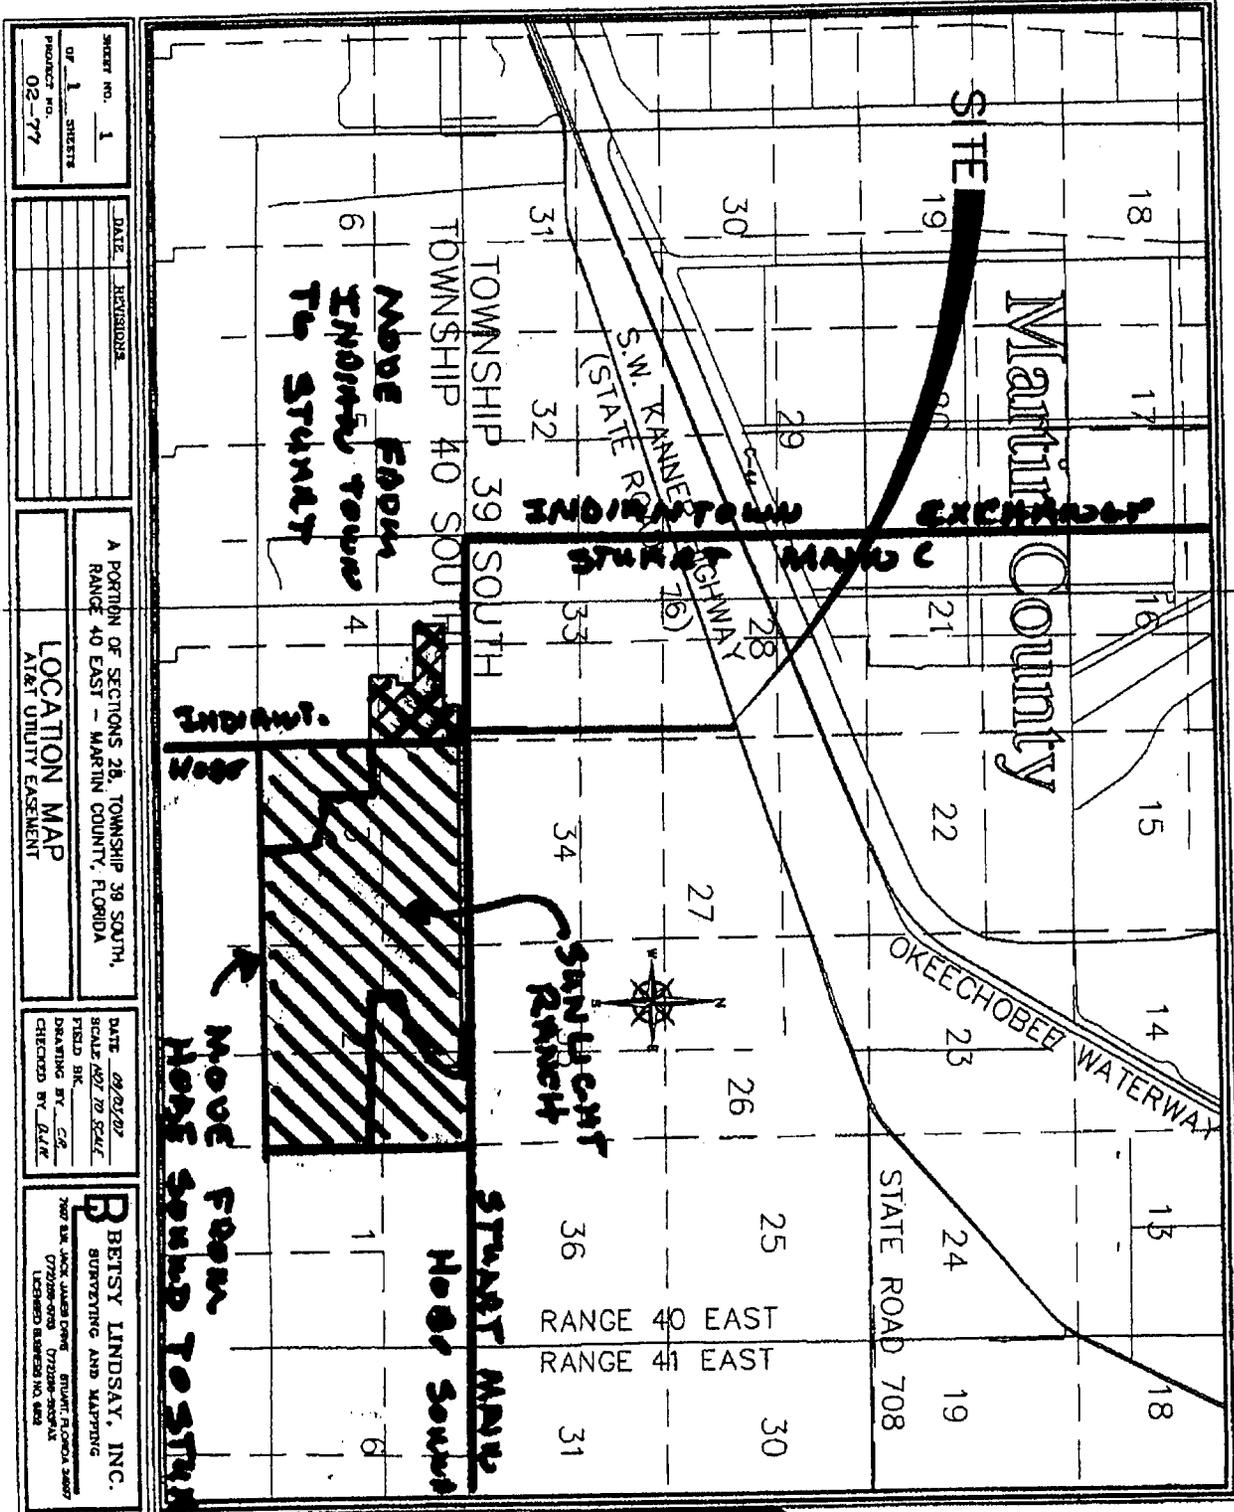

SHEET NO. 1
OF 1 SHEETS
PROJECT NO. 02-77

DATE	REVISIONS

A PORTION OF SECTIONS 28, TOWNSHIP 39 SOUTH, RANGE 40 EAST - MARTIN COUNTY, FLORIDA
LOCATION MAP
A/E UTILITY EASEMENT

DATE 09/20/02
SCALE 60' TO 1" AS SHOWN
DRAWING BY C.C.
CHECKED BY D.L.K.

B BETSY LINDSAY, INC.
SURVEYING AND MAPPING
702 E. JACK JAMES DRIVE SUITE 100, CORAL GABLES, FLORIDA 33134
(305) 444-1111

EXHIBIT
"A"

DOCUMENT NUMBER-DATE

02687 APR-8 88

FPSC-COMMISSION CLERK

GENERAL SUBSCRIBER SERVICES TARIFF

ITS TELECOMMUNICATIONS
SYSTEMS, INC.

FPSC Tariff No. 2
SECTION 3
Seventh Revised Sheet 1
Cancels Sixth Revised Sheet 1

BASIC LOCAL EXCHANGE SERVICE

3.1 GENERAL

- 3.1.1 a. The rates specified herein entitle subscribers to an unlimited number of messages to all stations bearing the designation of the Indiantown exchange and, through flat rate extended area service (EAS), to all stations bearing the designation of the Stuart exchange.
- b. A map showing the Indiantown Exchange (local calling area) has been filed and made a part of this tariff. The boundaries of the Stuart exchange are shown in the Southern Bell Telephone and Telegraph Company tariff.
- c. A map showing the elimination of six subdivision lots in the Sunlight Ranch Subdivision in the northeast quarter of Section 4, Township 40 South, Range 40 East, Martin County, Florida, and the transfer of the lots to AT&T Florida, approved by the Commission by Order No. PSC-08-0106-PAA-TL, Docket No. 070738-TL, issued February 19, 2008, was filed by the Company on April 8, 2008.

T

N
|
N

3.2 RATES AND APPLICATION

3.2.1 Within the local calling area monthly access line charges are as follows:

Residence Access Line	- \$ 9.42
Cable Pair (Off Premise Extension)	- \$ 7.88
Business Access Line	- \$22.13
Trunk Line (Key System)	- \$30.65
Trunk Line (PBX)	- \$44.23

(See Cross Reference Sheet for historical derivation.)

EFFECTIVE DATE:

ISSUED BY:
Jeff Leslie, President

GENERAL SUBSCRIBER SERVICES TARIFF

ITS TELECOMMUNICATIONS
SYSTEMS, INC.

FPSC Tariff No. 2
SECTION 3
~~Sixth Revised Sheet 1~~
Cancels ~~Fifth Revised Sheet 1~~

Seventh

BASIC LOCAL EXCHANGE SERVICE

3.1 GENERAL

- 3.1.1 a. The rates specified herein entitle subscribers to an unlimited number of messages to all stations bearing the designation of the Indiantown exchange and, through flat rate extended area service (EAS), to all stations bearing the designation of the Stuart exchange.
- b. A map showing the Indiantown Exchange (local calling area) ~~is filed herewith~~ and made a part of this tariff. The boundaries of the Stuart exchange are shown in the Southern Bell Telephone and Telegraph Company tariff.

c. a map showing the elimination of six

3.2 RATES AND APPLICATION

3.2.1 Within the local calling area monthly access line charges are as follows:

Residence Access Line	- \$ 9.42	+
Cable Pair (Off Premise Extension)	- \$ 7.88	+
Business Access Line	- \$22.13	+
Trunk Line (Key System)	- \$30.65	+
Trunk Line (PBX)	- \$44.23	+

subdivision lots in the Sunlight Ranch Subdivision in the northeast quarter of Section 4, Township 40 South, Range 40 East, Martin County, Florida, and the transfer of the lots to AT&T Florida, approved by the Commission by Order No. PSC-08-0106-PAA-TL, Docket No. 070738-TL, issued February 19, 2008, was filed by the Company on or about April 8, 2008

(See Cross Reference Sheet for historical derivation.)

EFFECTIVE DATE:

ISSUED BY:

Jeff Leslie
~~Robert M. Post, Jr.~~
President